


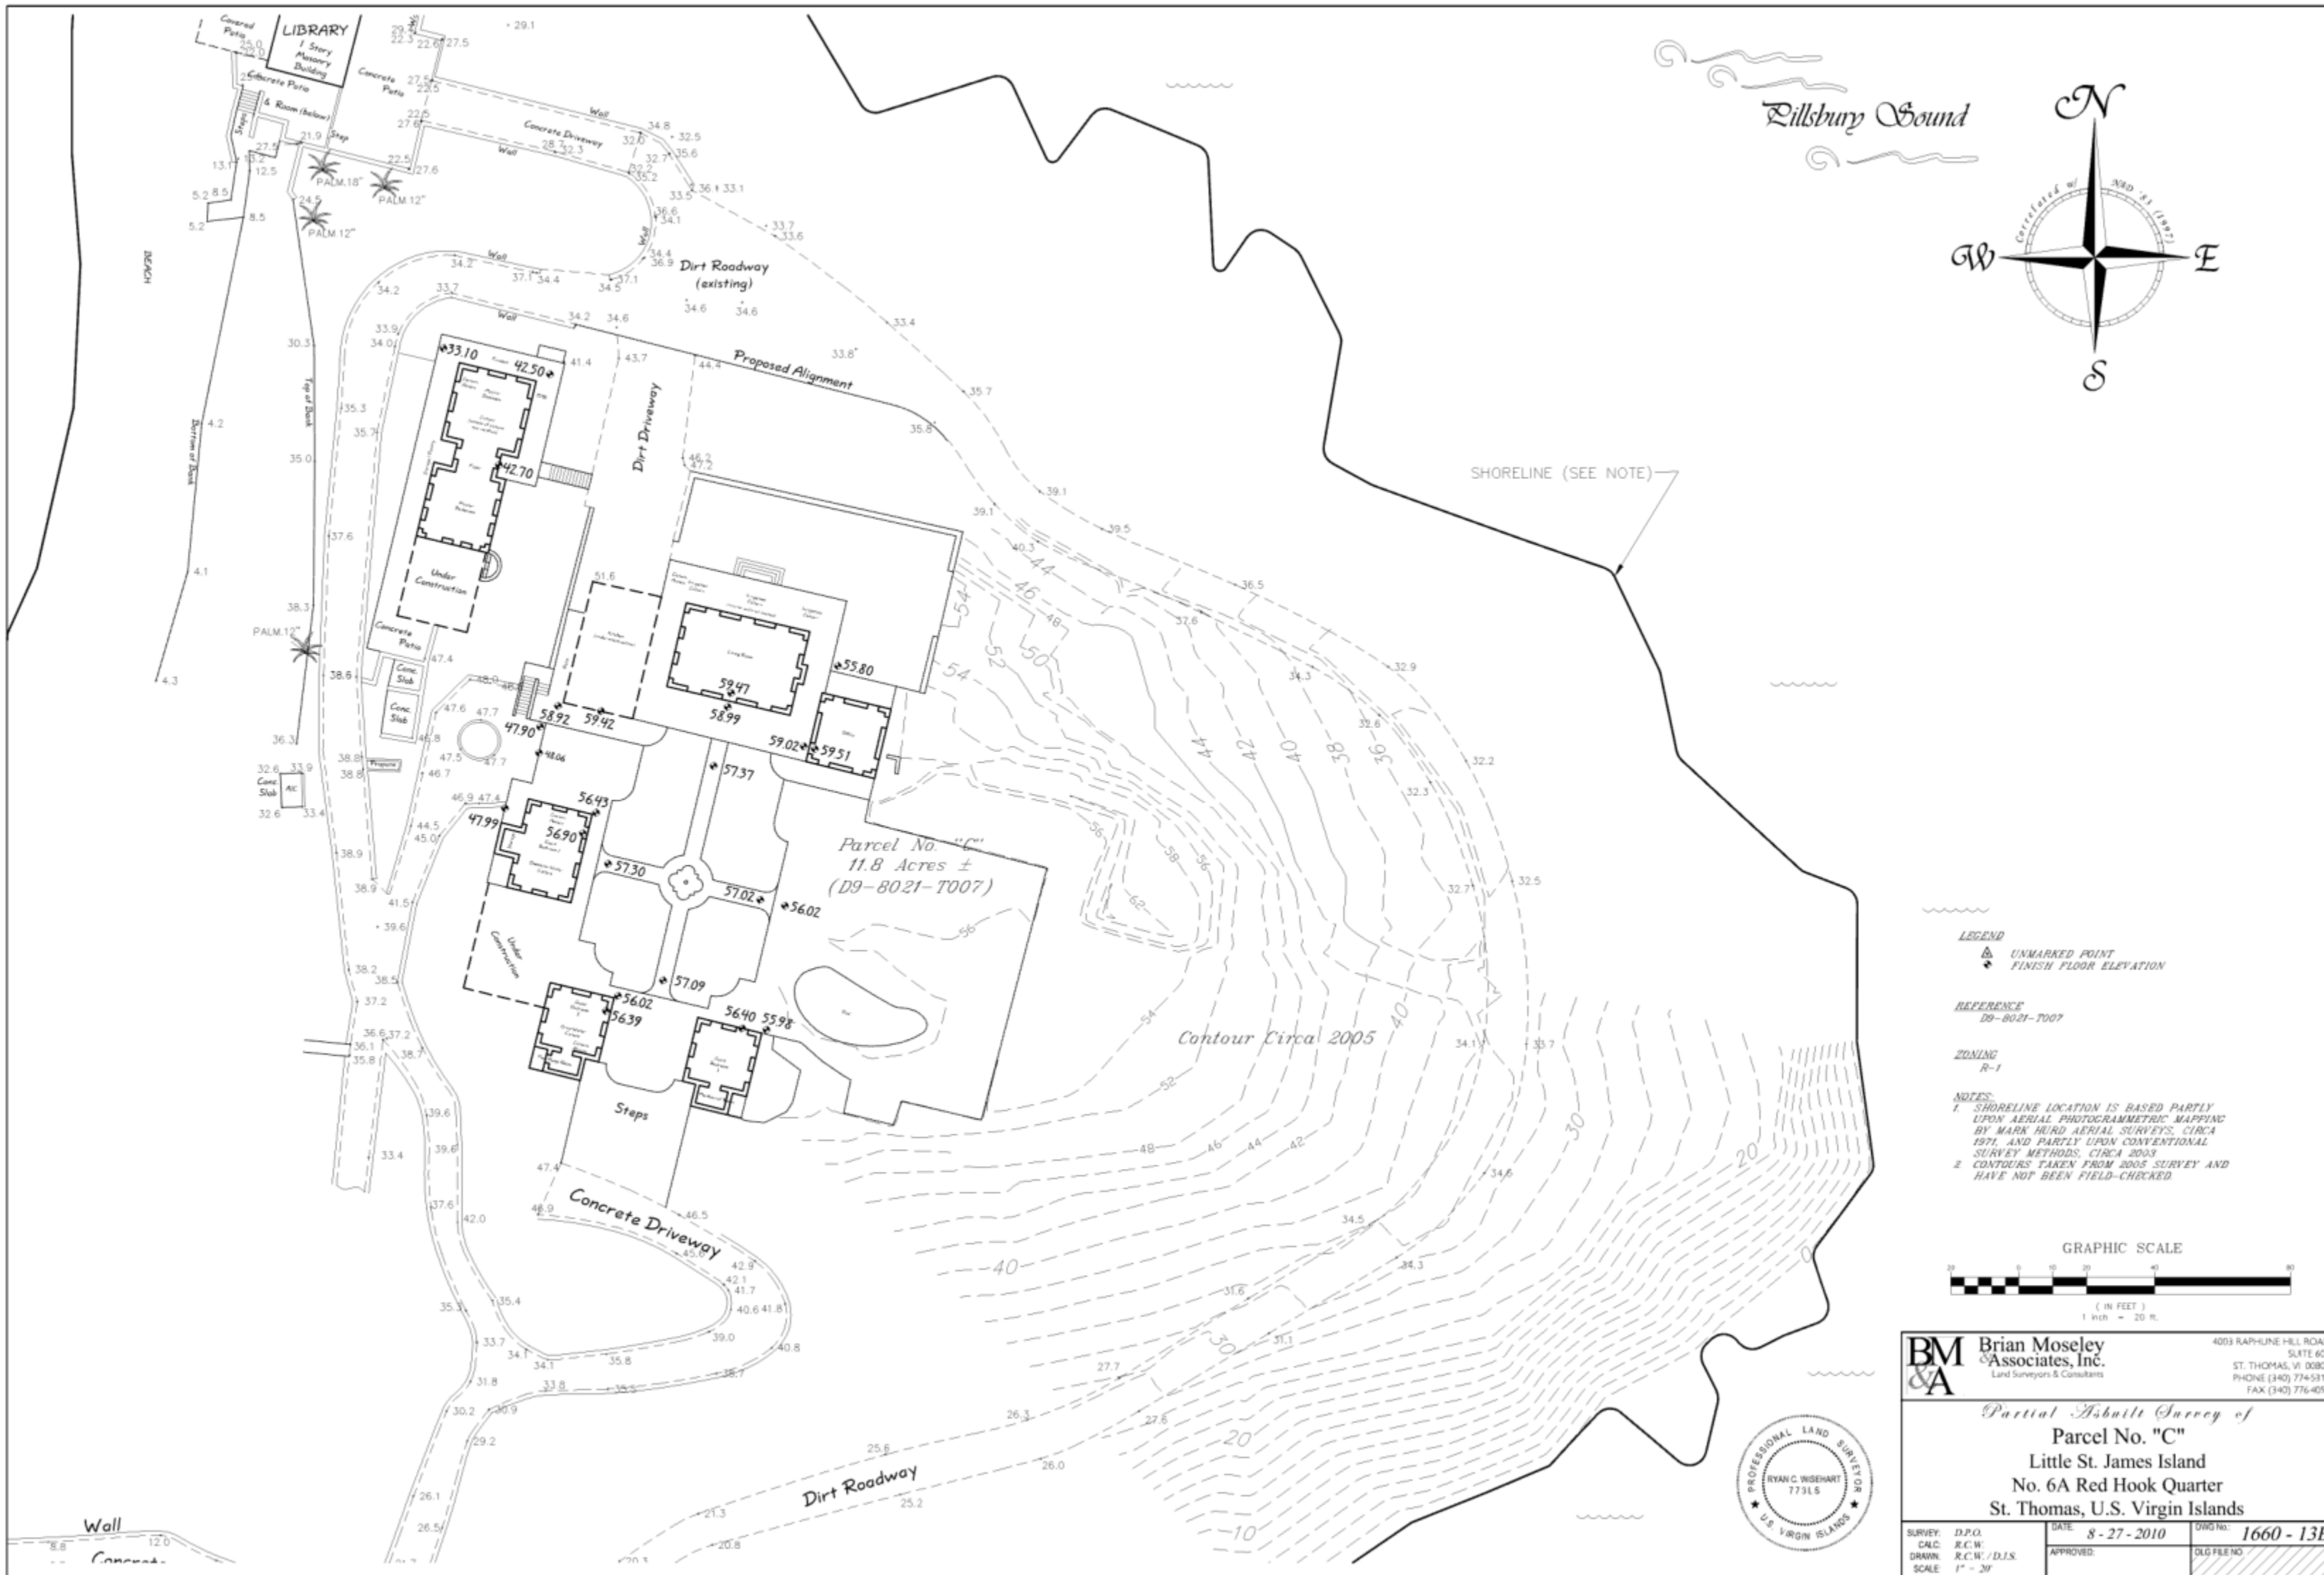

**LEGEND**  
UNMARKED POINT  
FINISH FLOOR ELEVATION

**REFERENCE**  
D9-8021-T007

**ZONING**  
R-1

**NOTES:**  
1. SHORELINE LOCATION IS BASED PARTLY UPON AERIAL PHOTOGRAMMETRIC MAPPING BY MARK HURD AERIAL SURVEYS, CIRCA 1971, AND PARTLY UPON CONVENTIONAL SURVEY METHODS, CIRCA 2009.  
2. CONTOURS TAKEN FROM 2005 SURVEY AND HAVE NOT BEEN FIELD-CHECKED.

**GRAPHIC SCALE**  
( IN FEET )  
1 inch = 20 ft.

**BM & A** Brian Moseley Associates, Inc.  
Land Surveyors & Consultants  
4003 RAPHUNE HILL ROAD  
SUITE 606  
ST. THOMAS, VI 00802  
PHONE (340) 774-5310  
FAX (340) 776-4090

*Partial As-built Survey of*  
**Parcel No. "C"**  
**Little St. James Island**  
**No. 6A Red Hook Quarter**  
**St. Thomas, U.S. Virgin Islands**

|        |               |           |              |
|--------|---------------|-----------|--------------|
| SURVEY | D.P.O.        | DATE      | DWG No.      |
| CALC.  | R.C.W.        | 8-27-2010 | 1660-13B     |
| DRAWN  | R.C.W./D.J.S. | APPROVED  | DWG FILE NO. |
| SCALE  | 1" = 20'      |           |              |